


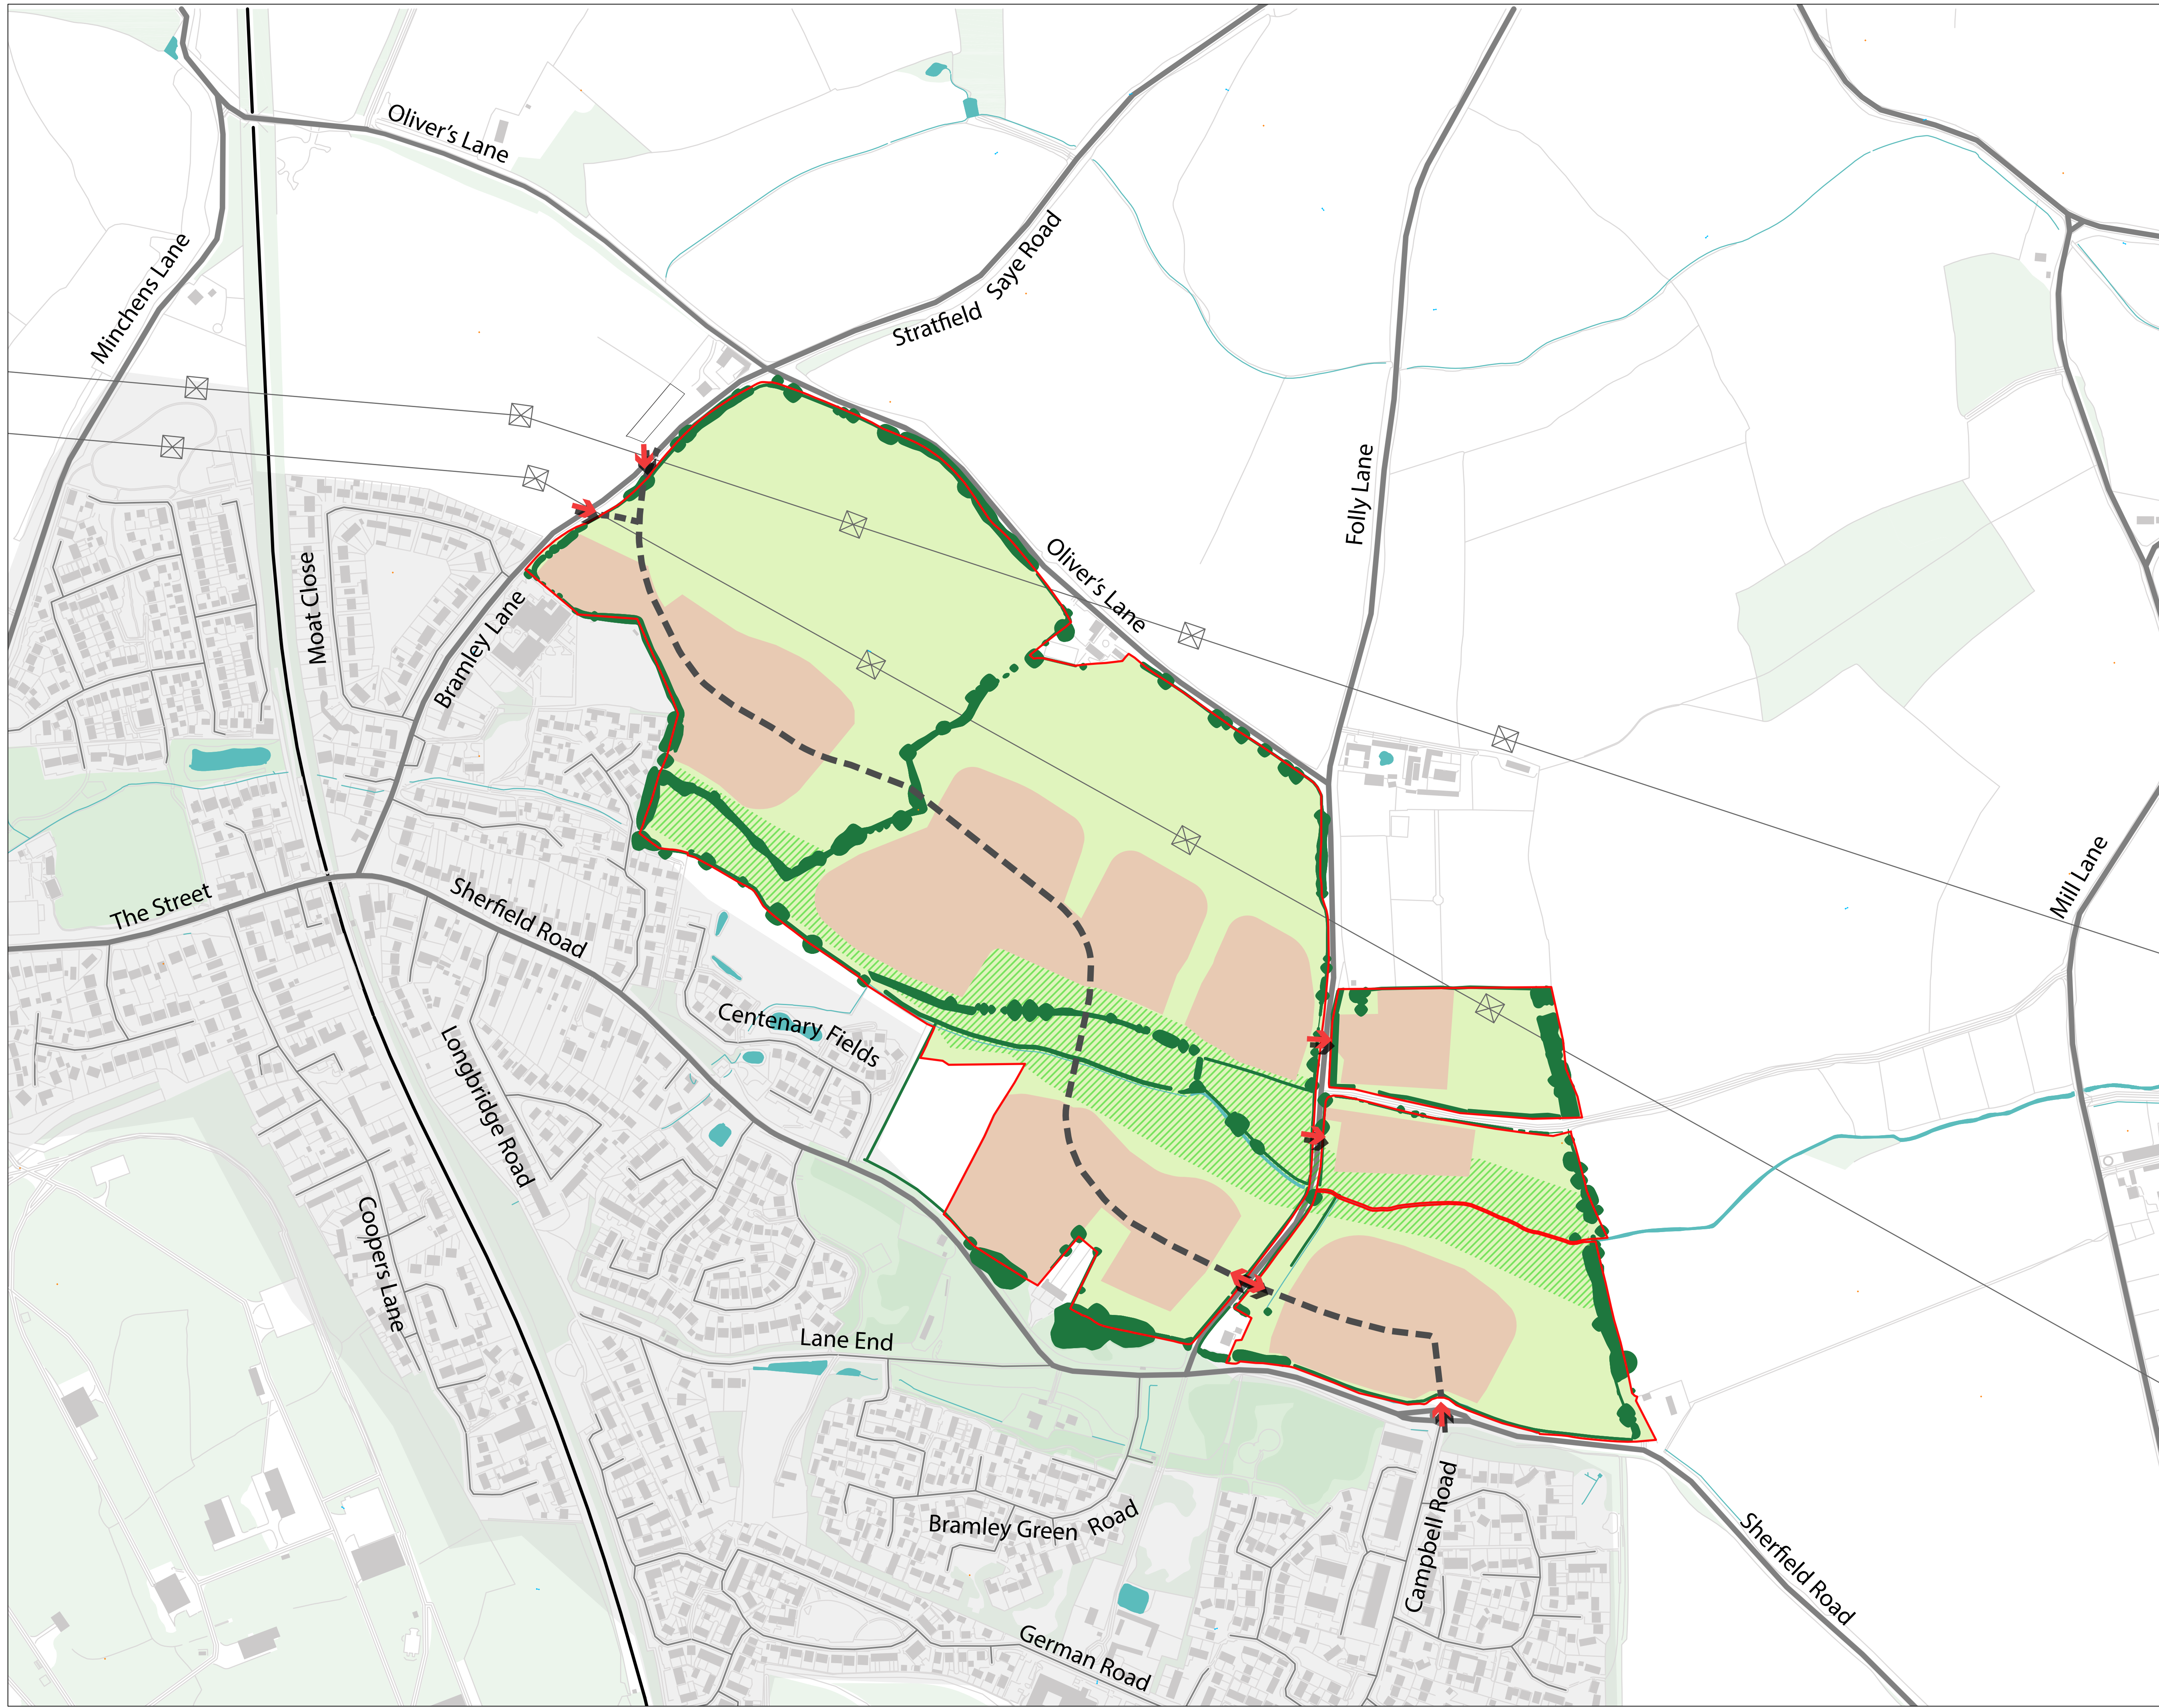

The scaling of this drawing cannot be assured

Revision	Date	Dwn	Ckd

LEGEND

- Site Boundary
- Proposed Development Areas
- Primary Route
- Potential Access Points
- Public Open Space
- Areas Appropriate for Drainage
- Retained Trees and Hedgerows
- Existing Watercourse

Project
Bramley Meadows

Drawing Title
Draft Concept Plan

Date 23.07.25	Scale 1:10,000@A1	Drawn by AO	Check by RS
Project No 333101948	Drawing No BL-M-03	Revision -	

 **Stantec**

Stantec UK Limited
101 Victoria Street
Bristol
BS1 6PU
T: 0117 929 9677

 **ISO 9001**
certified

stantec.com\uk